



City of
Burnaby

BOARD OF VARIANCE REFERRAL LETTER

DATE: Sept 29, 2015	DEADLINE: Oct 13, 2015 for the Nov 5, 2015 hearing		<i>This is <u>not</u> an application. Please take letter to Board of Variance. (Clerk's office - Ground Floor)</i>		
NAME OF APPLICANT: Tony Gill					
ADDRESS OF APPLICANT: 9558 134 St., Surrey V3V 5S5					
TELEPHONE: 604-728-3078					
PROJECT					
DESCRIPTION: New single family dwelling					
ADDRESS: 7357 Newcombe Street					
LEGAL:	LOT: 32	DL: 25	PLAN: 14945		

The above mentioned application, which includes the attached plan of the proposal, has been refused by the Building Department on the basis of contravention of:

Zone/Section(s) R10 [6.3.1]
of the Burnaby Zoning Bylaw No. 4742

COMMENTS:

The applicant is proposing to build a new single family dwelling. The following relaxation is being requested.

- 1) The distance between the principal building and the detached garage is 0.53 feet where a minimum distance of 14.8 feet is required.

Note: A previous Board of Variance (B.V. 6177) denied an appeal requesting the front yard setback of 24.93 feet measures to the foundation where a minimum front yard setback of 40.63 feet is required.

Note: A previous Board of Variance (B.V. 6190) denied an appeal requesting the front yard setback of 33.86 feet measures to the foundation where a minimum front yard setback of 40.63 feet is required; and allowed the distance between the principal building and the detached garage of 9.75 feet where a minimum distance of 14.8 feet is required.

Note: The applicant recognizes that should the project contain additional characteristics in contravention of the zoning by-law a future appeal(s) may be required.

BHS

Peter Kushnir
Deputy Chief Building Inspector

BUILDING DEPARTMENT

GENERAL NOTES


Plans by dimension. All dimensions are in feet and inches. All dimensions are to be measured from the exterior wall of the building. All dimensions are to be measured from the exterior wall of the building. Any deviation from these dimensions will require a change order. Please note that all dimensions are to be measured from the exterior wall of the building.

NOTICE OF THIS PLAN APPROVED FOR OTHER PLANS

COMMISSION

Complaints, observations, or recommendations of service will be referred to the appropriate commission. This is not a matter of design. This is a matter of construction. If you have any questions, please contact your local building department. The plans are not to be submitted or considered without the written consent of the commission.

THESE PLANS
CONFORM TO
BCBC 2012

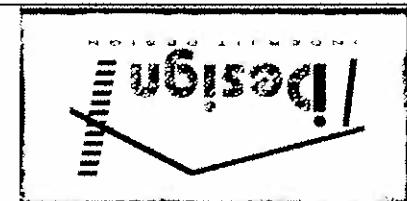


ADDRESS:
Unit 301 - 8144 122 St
Payne Building Centre
Burnaby BC
Contact us: 604-543-4427
www.burnabyplans.ca

MAIN FLOOR
Scale 1/4" = 1'-0"
Floor Area = 1920 sq ft

CELLAR
Scale 1/4" = 1'-0"
Floor Area = 344 sq ft

Location: Burnaby B.C.
Address: 7357 Newcombe St
Floor Plans
Date: 26 Aug 2015
Scale: 1:48
Page: 2 of 6

BEGIVED
06/01/2015

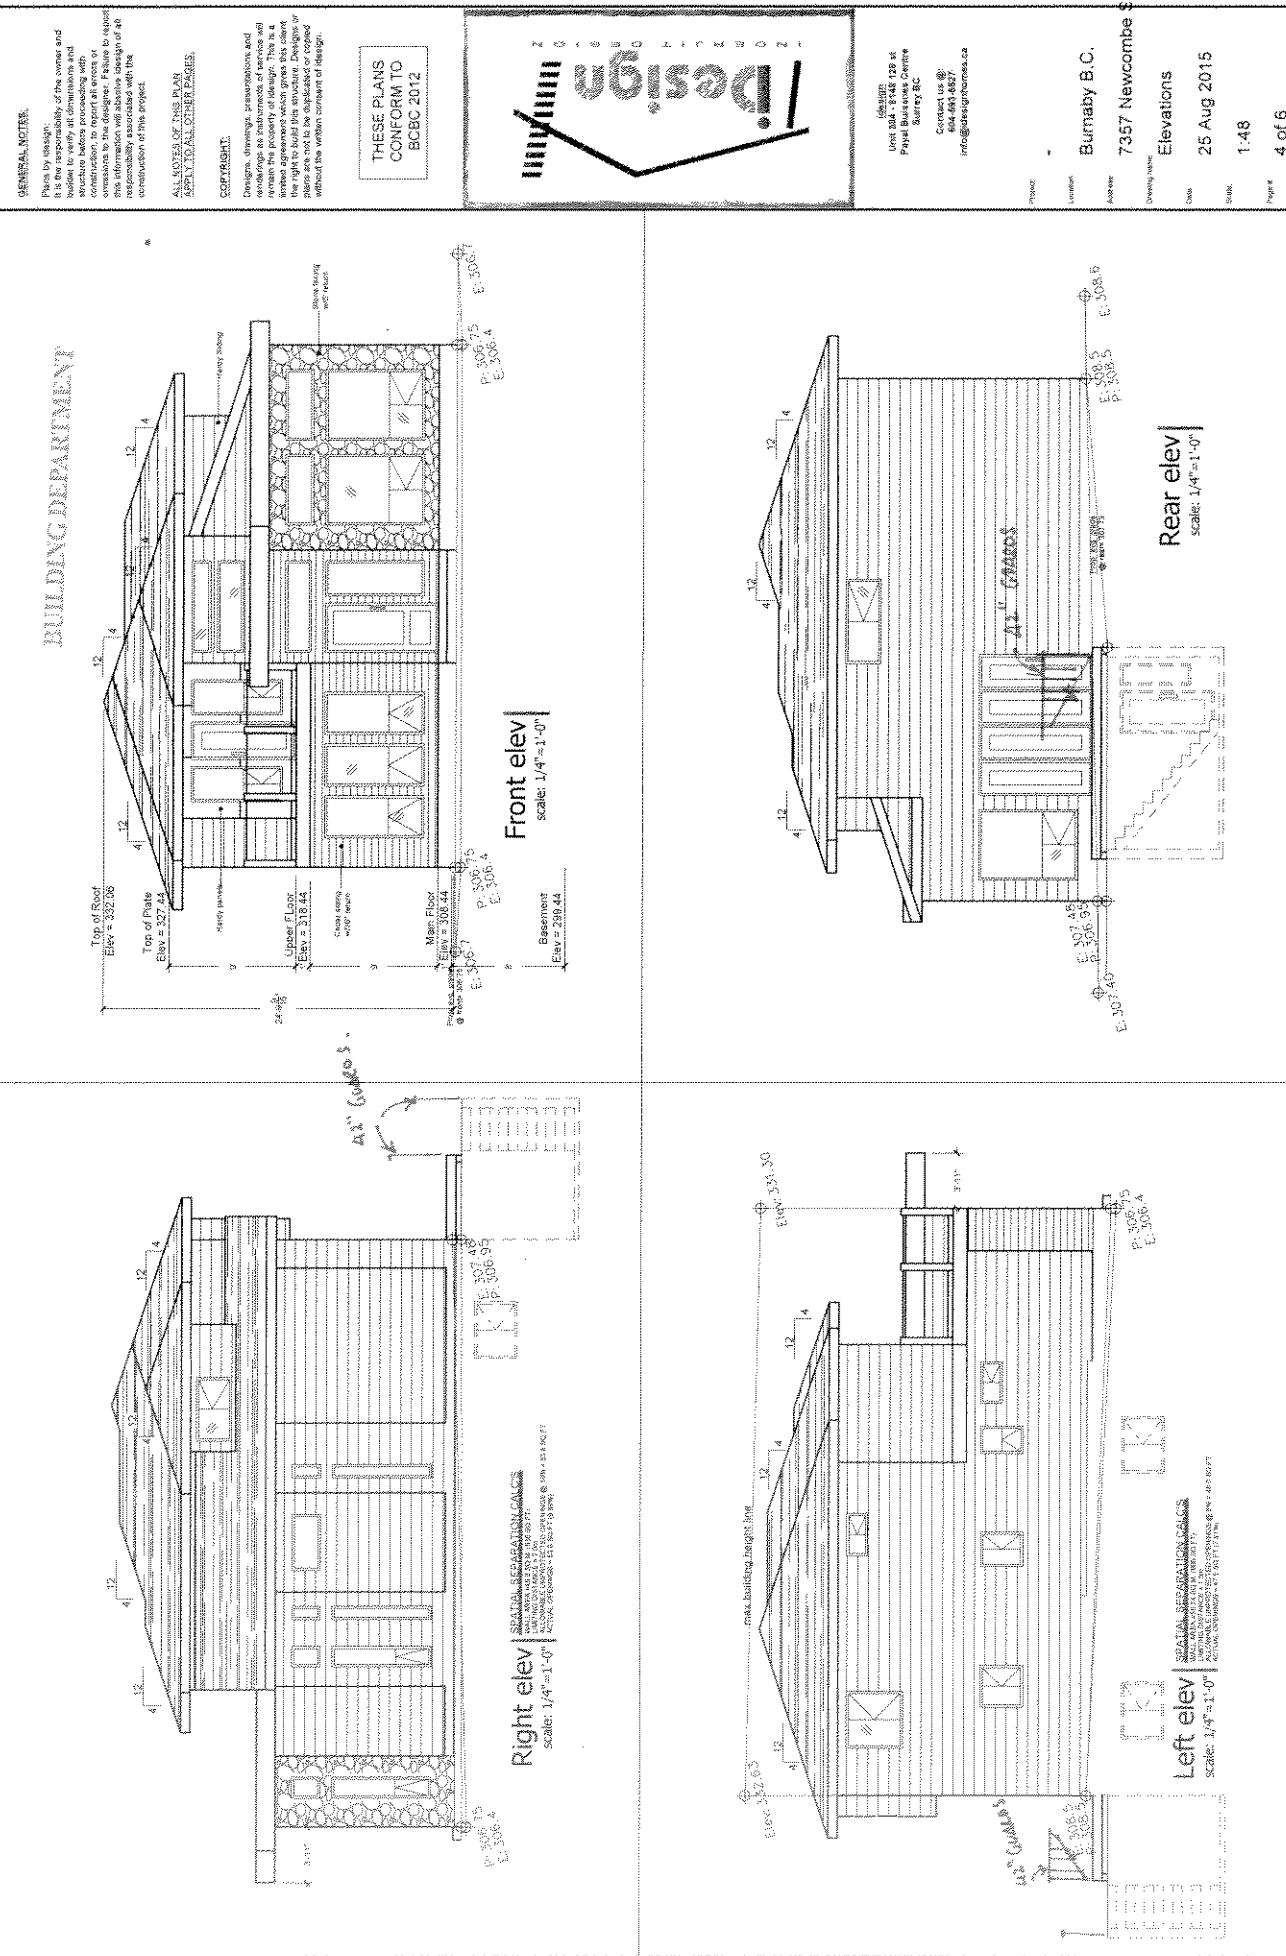


RECEIVED

JU MAY 21 2015

TOPOGRAPHICAL PLAN OF LOT 32 BLOCK "D" DISTRICT
LOT 25 GROUP 1 NWD PLAN 14945

Scale: 1 inch = 15 feet
The horizontal scale of this plan is 560 feet by 148 feet.
(560 inches plus a scale of .560 feet by 14.8 feet)
All dimensions given are in feet and fractions
Level lines & contour lines shown.

Legend:
 - Standard Ave Pave
 - Land Pave
 - Faded Avenue or road
 - Survey Point
 - Survey Pole
 - Burial
 - Directional arrow
 - Traffic
t - Elevation at End of Line

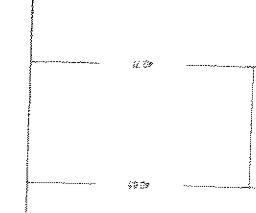

Notes:
 Easton Ave.
 Elevation 14945
 Reference to Asurveyor P-24-17
 Government Surveyor #2.550m


34
 P-24 14945
 Survey #225

33
 P-24 14945
 Survey #241

32
 Proposed
 Building Envelope
 (Zoning R10)

30
 P-24 14945
 Survey #237
 Drawing #230

37
 P-24 14945
 Drawing #275

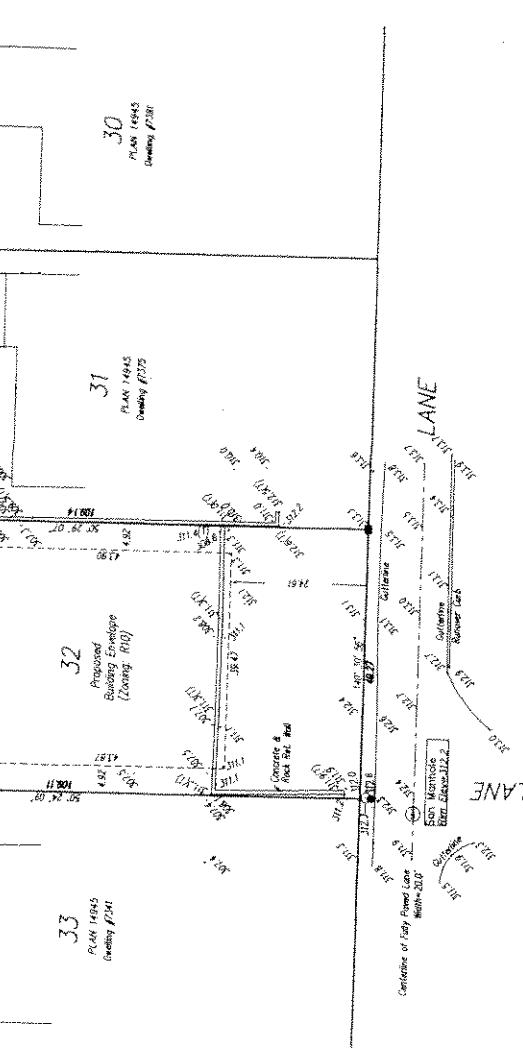

Note:
 Information shown here is for enclosure purposes only
 and is the exclusive use of the owner.
 All rights reserved. No portion may copy, re-copy,
 transcribe, alter, paste, or store copies of this document
 or parts of it, without the prior written consent
 of the copyright.
 Displaying uncopyable screens is duly appropriate.
 For enforcement of City Building Admin
 Office General Planning Department for local
 zoning enquires when required.

Attn: Zoning #43-635

Lot	Front	Address
14	46.65	7125
15	45.5	7344
31	62.39	7125
40	58.49	7344

Grid bearings are derived from dimensions between
grid control monuments #47-412 and P-32-17.

Grid bearings are derived from dimensions between
grid control monuments #47-412 and P-32-17.

C:\Users\...\Downloads\2015-2015.dwg

As-Built

ANSI-3D10-2015

Sheet 208

Total Area: 13,648 SF

Date: 12/26/2015

File No. 14945

HUSING PLAN OF LOT 32 BLOCK "D" DISTRICT
LOT 25 GROUP 1 NWD PLAN 14945

Pursuant to Section 68 of the Land Title Act
B.C.S. 926.026

Scale 1:500
0 10 20 30 40 50
10' 20' 30' 40' 50'

The intended plot size of this plan is 432' width by 280' in height
(12' posts) when plotted at a scale of 1:500.

LEGEND:

- - Control Monument Found
- - Standard Iron Post Found
- - Lead Plug Found
- - Standard Iron Post Placed
- - Lead Plug Placed
- PP - Plotting Plan
- WT - Witness
- U - Unplotted

Deacon MARKET (1585) 44128C160
UTM Zone 10 5453422.362
UTM Northing 505324.087
Plot Control Factor 0.9995864
Plot Control Positional Accuracy 0.10mm
94H1432

BUILDING DEPARTMENT

RECEIVED
MAY 21 2015

UTM Coor 10
UTM Northing 5453422.362
UTM Easting 505324.087
Plot Control Factor 0.9995864
Plot Control Positional Accuracy 0.10mm

This Plan Shows Horizontal ground-level distances unless otherwise

specified. To compute grid distances, multiply ground-level distances
by the inverse combined factor of 0.9995864 which has been
derived from 94H1432 and P-52-17.

The UTM coordinates and estimated horizontal positional
accuracy achieved are derived from the MASCOT
published coordinates and standard deviations for
geodetic control monuments 94H1432 and P-52-17.

Note:
Grid boundaries are derived from observations between
geodetic control monuments 94H1432 and P-52-17.

Note:
This plan uses one or more witness posts
which are set along the production of property
boundary unless otherwise stated.

© Survey Land Services, Ltd. 2015

Lot 504-520-5208

The field survey represented by this plan was
completed on the 23rd day of April 2015
Loring Yuan, B.C.L.S. #859

File No. BL274-Boston

This Plan Lies Within The Greater
Vancouver Regional District

Note:
Some posts and lines have been
simplified for clarity.

File No. BL274-Boston